



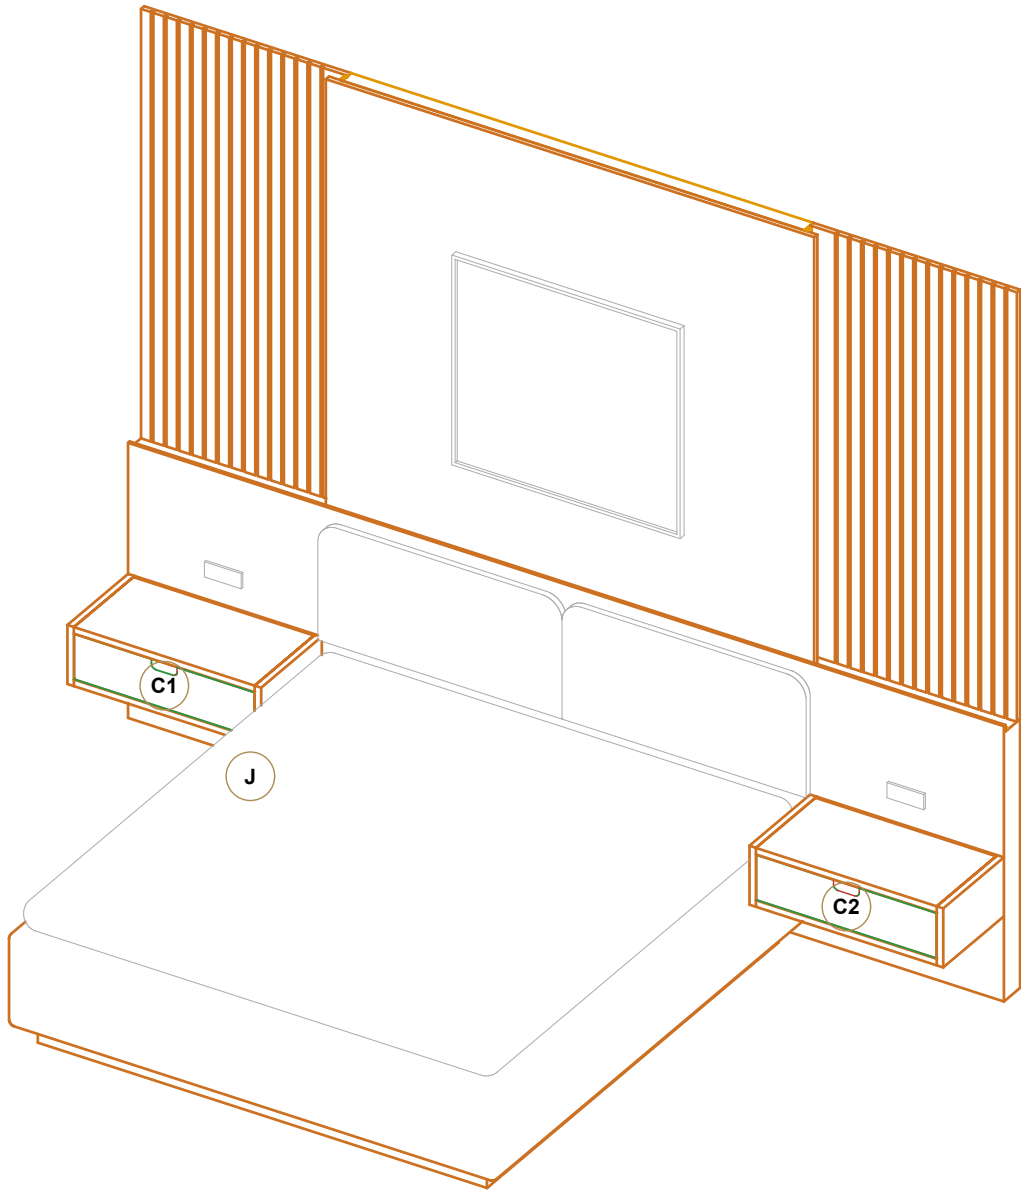


1 3D VIEW
AXONOMETRIC, DECOR GREY, INDICATIVE | SCALE 1:25

FURNITURE SCHEDULE


CODE	ITEM	MOUNTING	SIZE W x D x H	CARCASS / MAIN	FRONT / FINISH	OPENING	HARDWARE	LED
C1	FLOATING SIDE TABLE LEFT	WALL-HUNG	754 x 381 x 229	M3 OAK NATURAL LA	M3 OAK NATURAL LAM	1 DRAWER	HANGER, PULL, RUNNER	-
C2	FLOATING SIDE TABLE RIGHT	WALL-HUNG	754 x 381 x 229	M3 OAK NATURAL LA	M3 OAK NATURAL LAM	1 DRAWER	HANGER, PULL, RUNNER	-
J	WALL JOINERY & PANELLING (7 PC	WALL-FIXED	3408 x 2082 x 2707	M3 OAK NATURAL LA	M2 FABRIC PANEL LAM / M1 P	FIXED PANELS	-	1.8 M

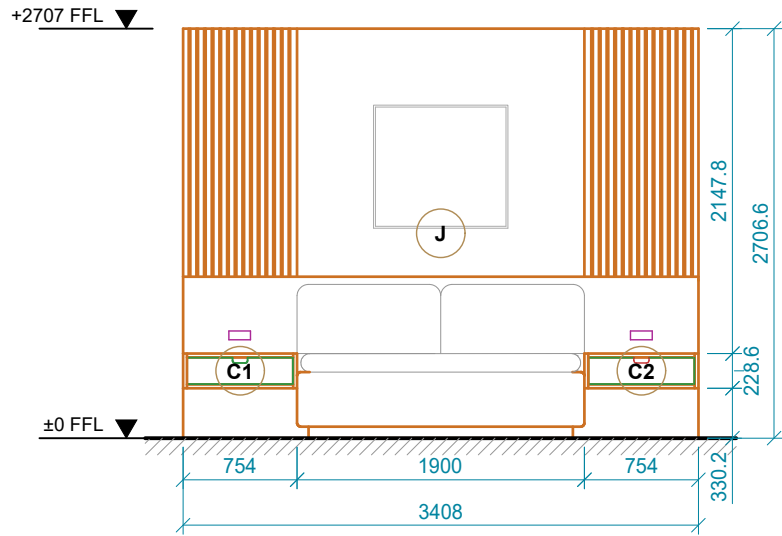

2 FRONT ELEVATION
OVERALL SIZES & ITEM CODES | SCALE 1:50

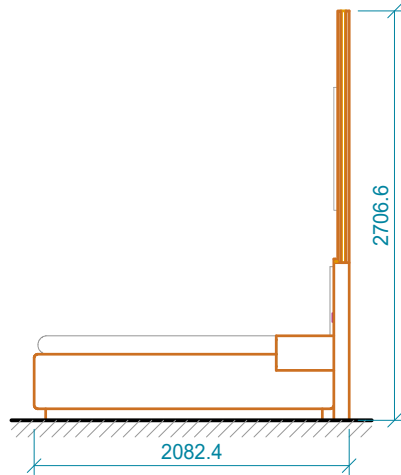

3 SIDE ELEVATION
FROM RIGHT | SCALE 1:50

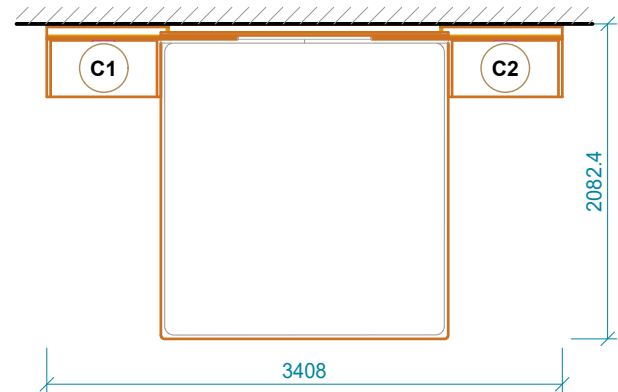

4 PLAN
TOP VIEW | SCALE 1:50



MAYA DESIGN & BUILD

ARCHITECTURE | INTERIORS | CONSTRUCTION

8980703374 · mayadb01@gmail.com · mayadb.in
Shop 5 seven lead arcade, dhamdod road · Bardoli

PROJECT
S.F GUEST BEDROOM - ELEVATION C (BED WALL)
CLIENT KAMLESHBHAI TEMKAR
SITE VYARA

SHEET NOTES
THIS SHEET SUMMARISES THE DESIGN FOR CLIENT REVIEW
AND SITE CO-ORDINATION.
SIZES ARE OVERALL W x D x H IN MM; REFER CABINET SHEETS
FOR WORKING DETAILS.
COST IS INDICATIVE (SEE BOQ SHEET FOR BASIS AND
EXCLUSIONS).
3D VIEW IS NOT TO SCALE.

DRAWING TITLE
FURNITURE SUMMARY - 3D VIEW, ELEVATION, PLAN & SCHEDULE

SCALE
1:50 / 3D NTS

DATE
17-10-2026





REV
R2

AS BUILT


DRAWING NO.
MDB-SFG-F01
SHEET 03/10 · A3

DRAWN Er.Lalit Choudhary · CHECKED
APPROVED Er.Lalit Choudhary


123456

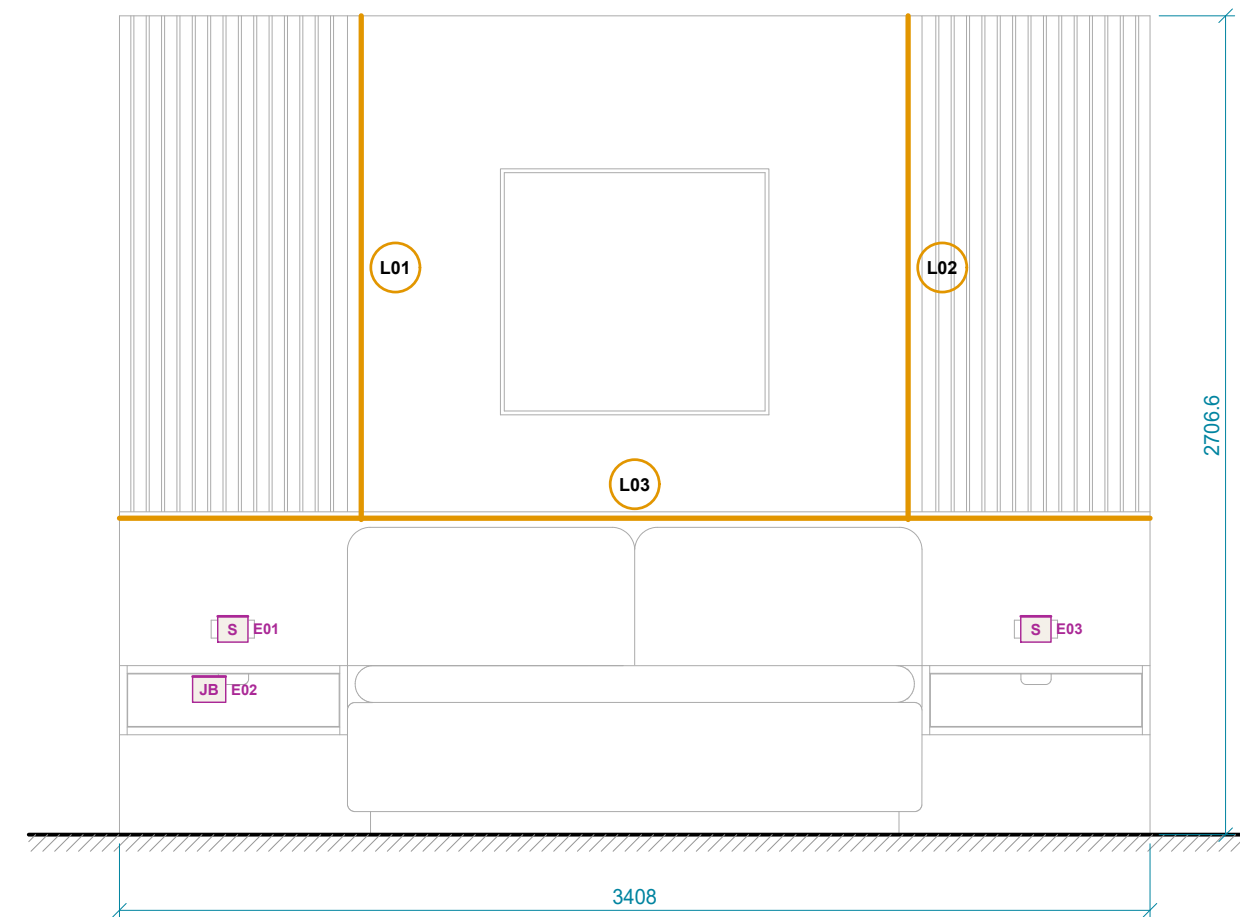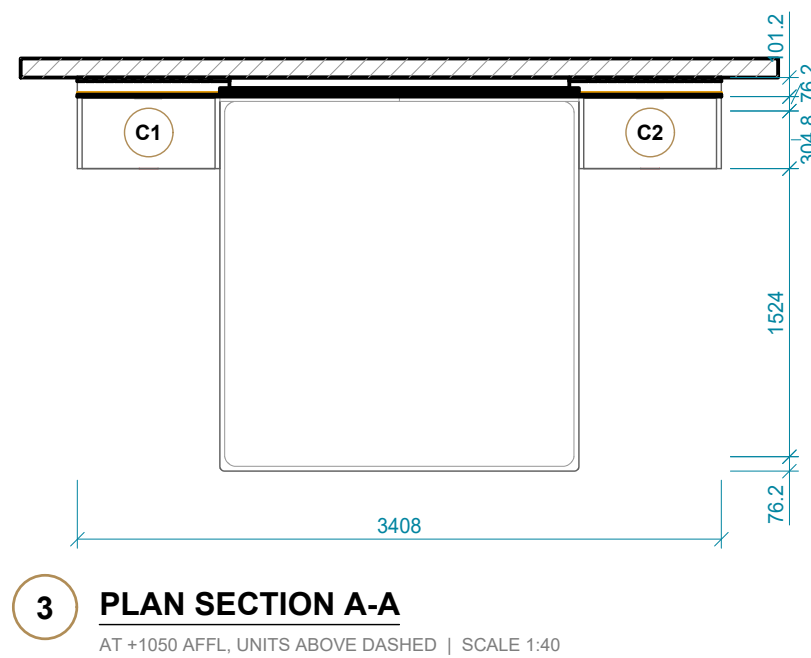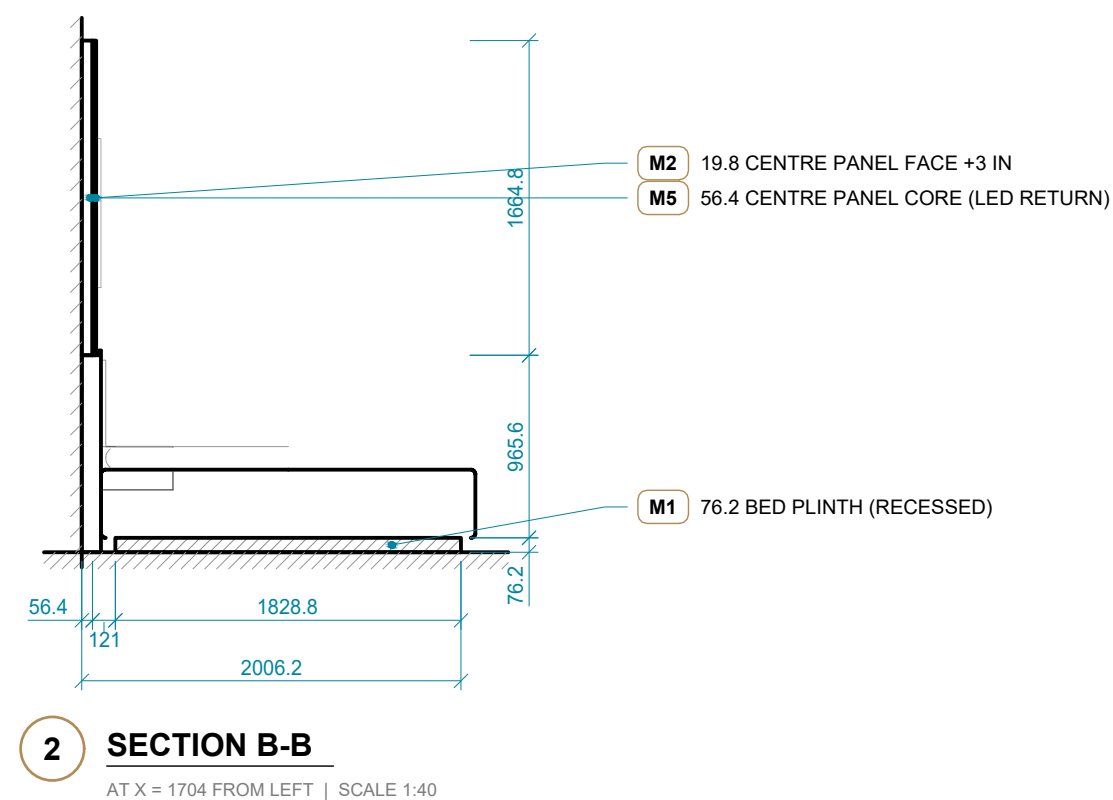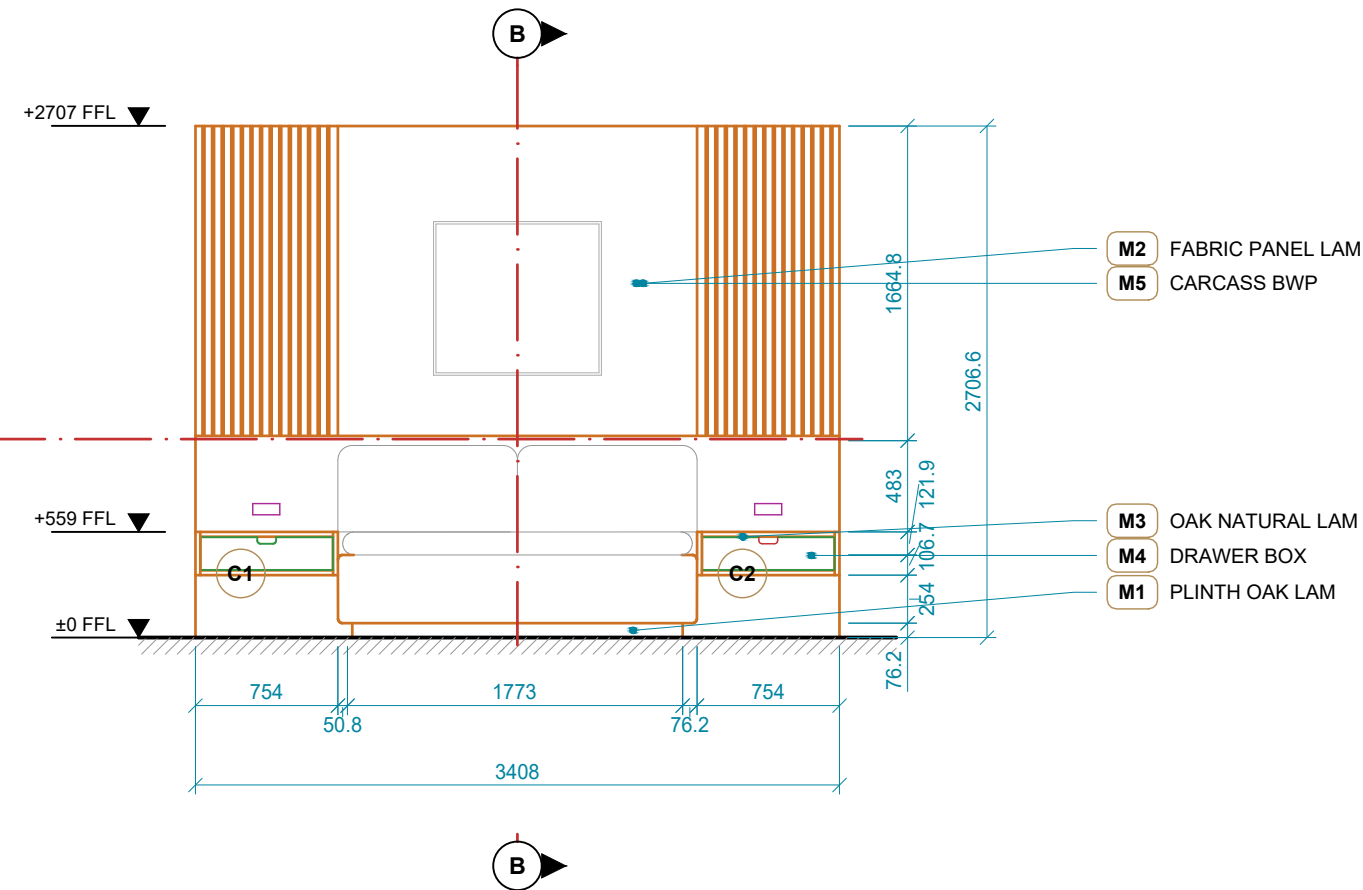


123456

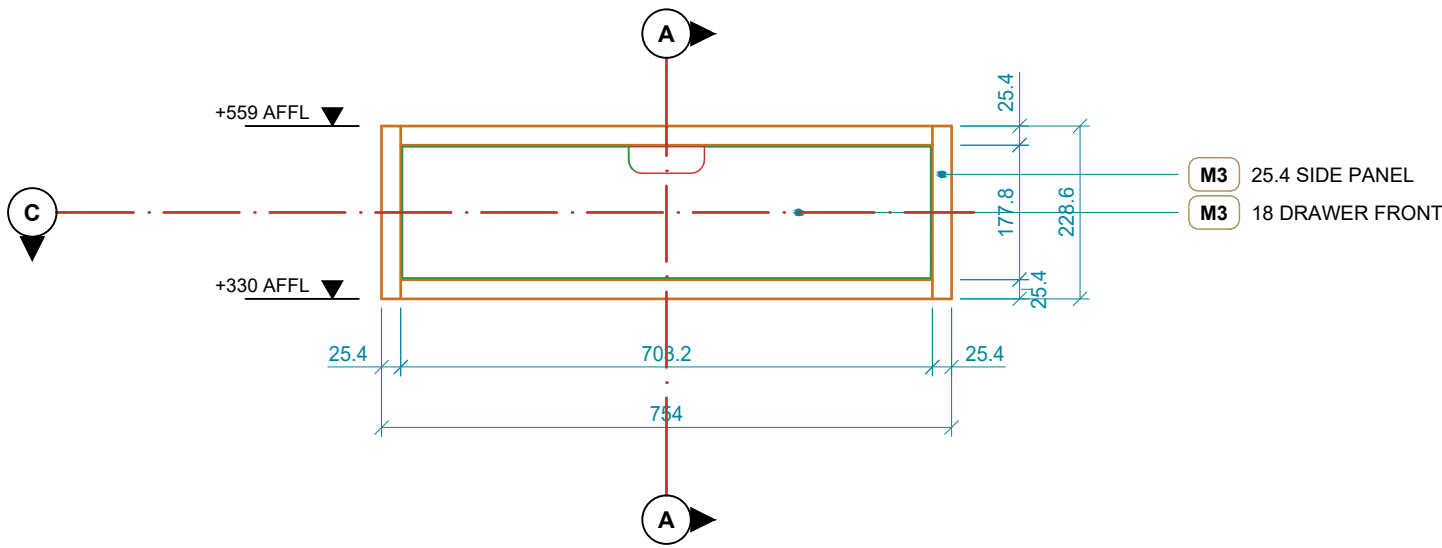


1 FRONT ELEVATION
DOORS CLOSED | SCALE 1:10

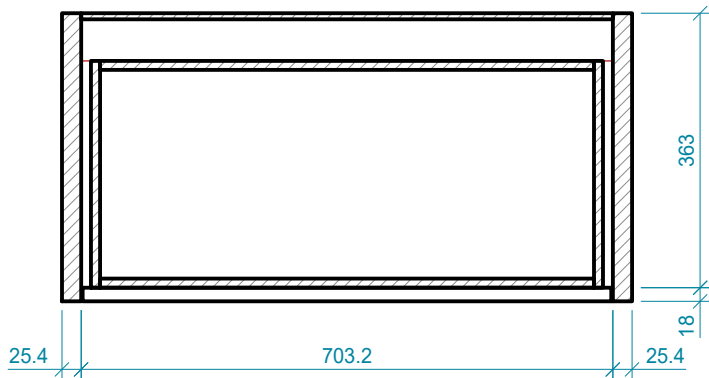


5 PLAN SECTION C-C
AT +445 AFFL | SCALE 1:10

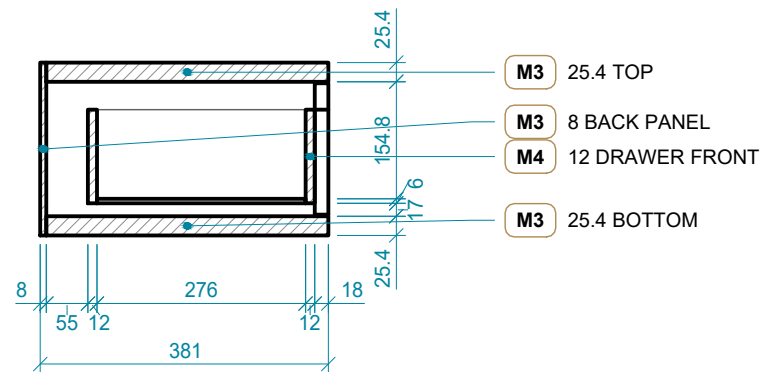


3 SECTION A-A
AT X = 377 FROM LEFT | SCALE 1:10

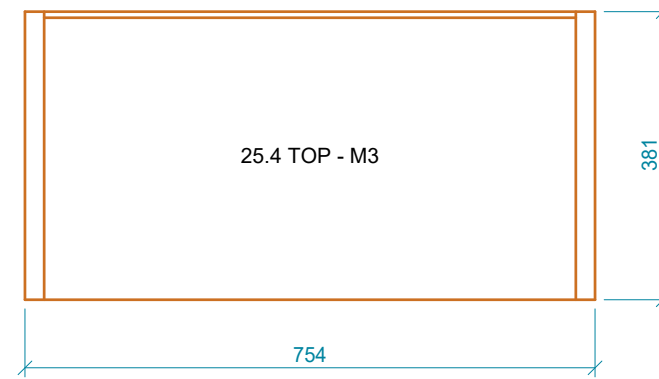


6 TOP VIEW
SCALE 1:10

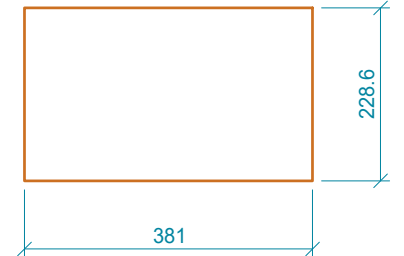

4 SIDE ELEVATION
RIGHT HAND SIDE | SCALE 1:10

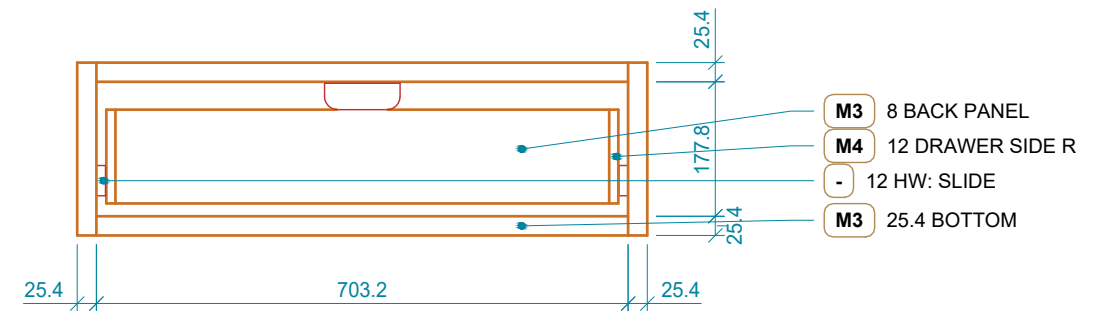


2 INTERNAL ELEVATION
FRONTS REMOVED | SCALE 1:10

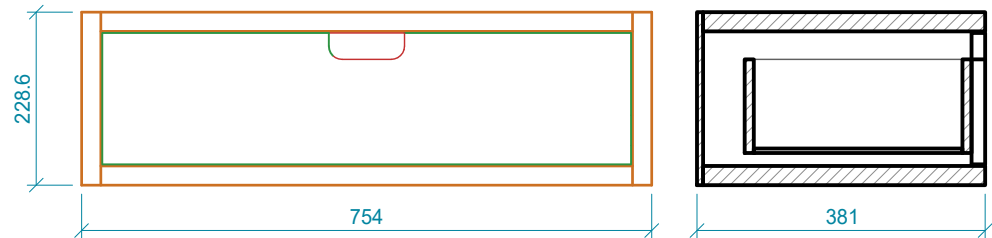


C1 FLOATING SIDE TABLE LEFT

754 W x 381 D x 229 H | +330 FFL
1 DRAWER + WALL-HUNG

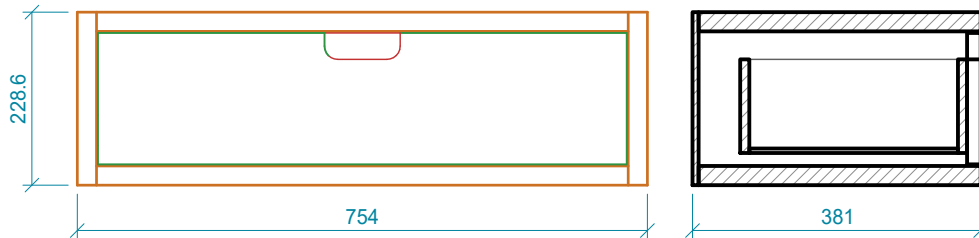

C2 FLOATING SIDE TABLE RIGHT


754 W x 381 D x 229 H | +330 FFL
1 DRAWER + WALL-HUNG

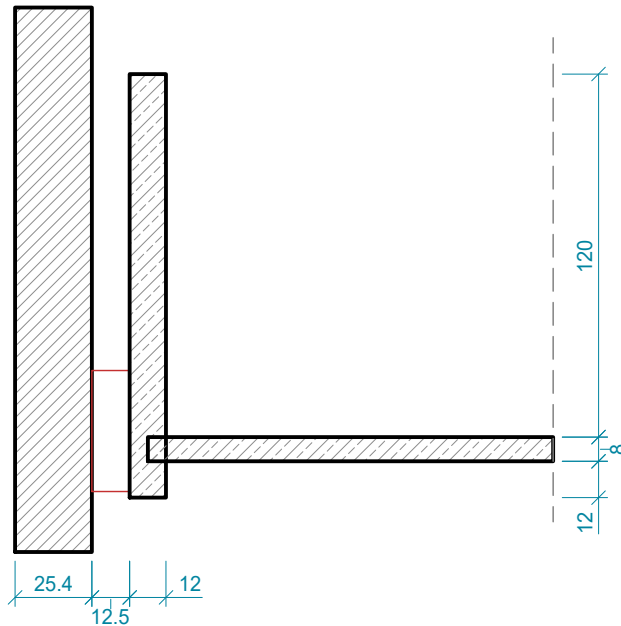

FRONT 18 THK, GAP 3 ALL ROUND
BOX SIDE 12, BOTTOM 8 IN 10 GROOVE
RUNNER CLEARANCE 12.5 EACH SIDE
BOX WIDTH = OPENING - 25

T1 DRAWER - TYPICAL


SECTION AT MID-DEPTH | SCALE 1:2.5

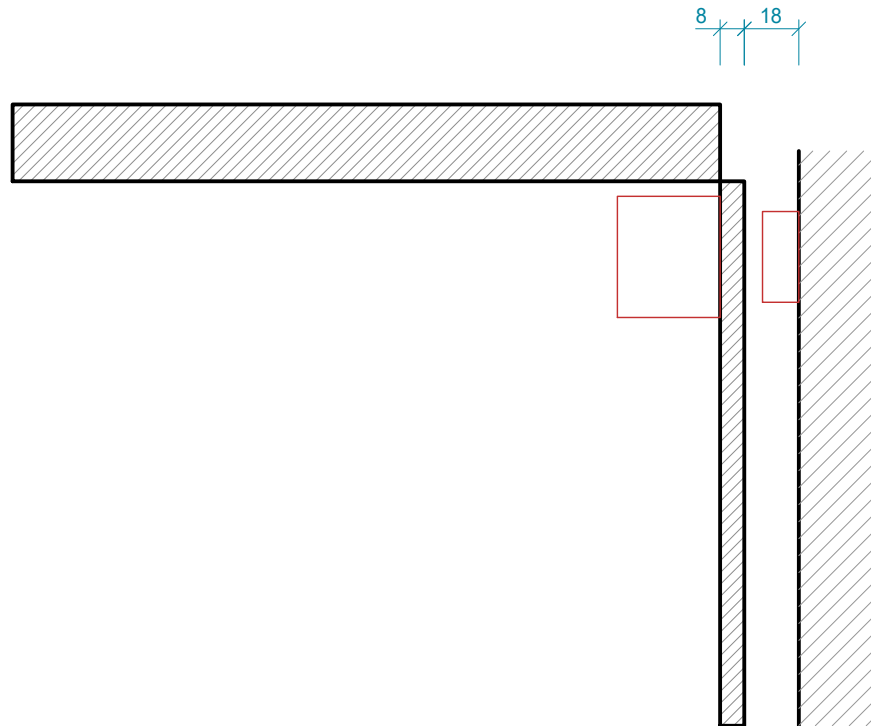

HETTICH CABINET HANGER (PAIR) + 2 M WALL RAIL
RAIL: 8 MM ANCHORS @ 300 C/C, LEVELLED
BACK SET IN 18 FOR HANGER SPACE
ADJUST HEIGHT / DEPTH AFTER HANGING

T2 WALL-HUNG FIXING

SECTION AT TOP-BACK CORNER | SCALE 1:2.5

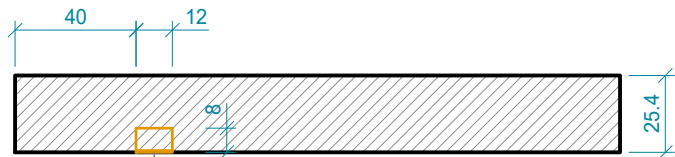

ALU PROFILE 12 x 8 RECESSED, OPAL DIFFUSER
40 FROM FRONT EDGE, 24 V COB 10 W/M
DRIVER IN JB POINT (SEE ELECTRICAL)

T3 LED PROFILE - TYPICAL

SECTION THROUGH SHELF / TOP | SCALE 1:2.5

LEGEND - SYMBOLS & HATCHES

SECTION CUT
CARCASS
SHUTTER
HIDDEN / SWING

HARDWARE
LED STRIP
DIMENSION
DECOR

PLY (CUT)
MDF / HDHMR
STONE / MARBLE
LEVEL (FFL)

C1 UNIT CODE
M3 MATERIAL TAG
A SECTION MARK
6A 6A SOCKET

16A 16A SOCKET
USB USB SOCKET
TV TV POINT
D DATA (RJ45)

S SWITCH
JB JB / DRIVER
H HDMI CONDUIT



MAYA DESIGN & BUILD

ARCHITECTURE | INTERIORS | CONSTRUCTION

8980703374 · mayadb01@gmail.com · mayadb.in
Shop 5 seven lead arcade, dhamdod road · Bardoli

PROJECT
S.F GUEST BEDROOM - ELEVATION C (BED WALL)

CLIENT KAMLESHBHAI TEMKAR
SITE VYARA

SHEET NOTES
UNIT SIZES ARE CARCASS SIZES (W x D x H).
TYPICAL DETAILS APPLY TO ALL UNITS UNLESS NOTED.
CUT LIST: WORKING SET / CUT LIST CSV.
MATERIAL TAGS: SEE SHEET 1.

DRAWING TITLE
SITE SUMMARY 2 OF 2 - UNITS, TYPICAL DETAILS, HARDWARE & ELECTRICAL

SCALE
1:10 / DETAILS 1:2.5

DATE
17-10-2026

REV
R2

AS BUILT

DRAWING NO.
MDB-SFG-SS02
SHEET 02/10 · A3

DRAWN Er.Lalit Choudhary · CHECKED
APPROVED Er.Lalit Choudhary